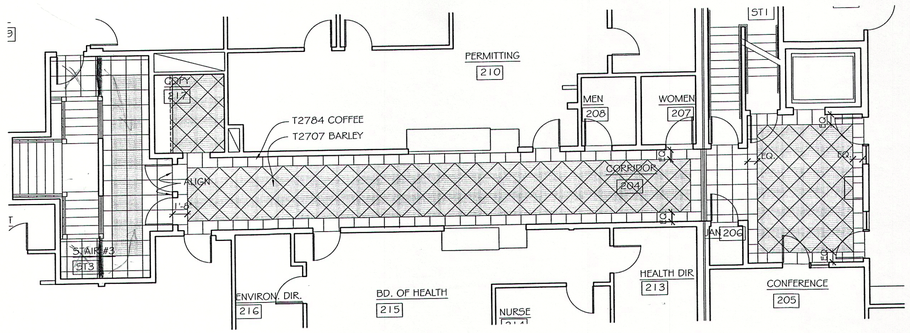

1 SECOND FLOOR PLAN

LINOLEUM FLOOR PATTERN -SECOND FLR
WESTFORD TOWN HALL ADDITION & RENOVATIONS
55 MAIN STREET, WESTFORD, MA
KANG ASSOCIATES, INC. 09/13/10 1/8" = 1'-0"
CSKA 19

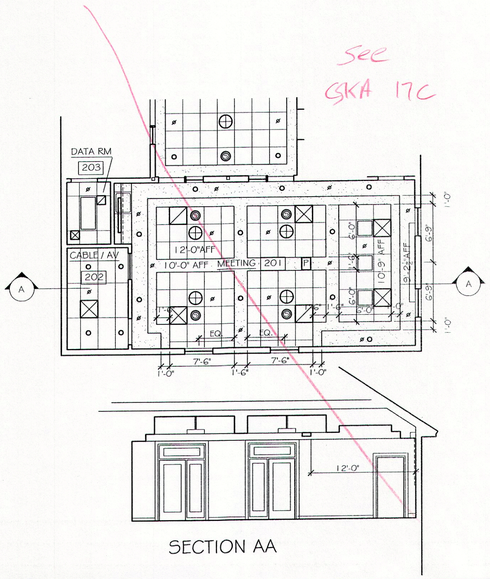

SECTION AA

MEETING ROOM CEILING REVISIONS
WESTFORD TOWN HALL ADDITION & RENOVATIONS
55 MAIN STREET, WESTFORD, MA
KANG ASSOCIATES, INC. 06/18/10 1/8" = 1'-0"
CSKA 17b

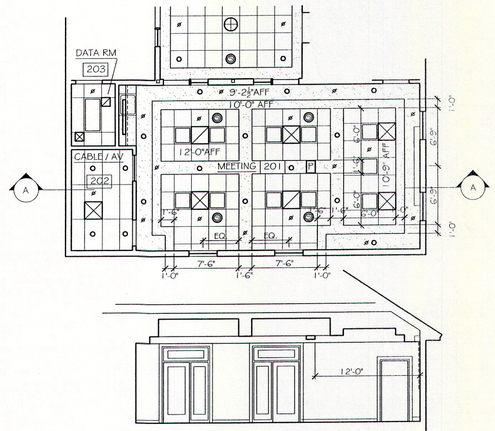

SECTION AA

MEETING ROOM CEILING REVISIONS
WESTFORD TOWN HALL ADDITION & RENOVATIONS
55 MAIN STREET, WESTFORD, MA
KANG ASSOCIATES, INC. 06/18/10 1/8" = 1'-0"
CSKA 17a

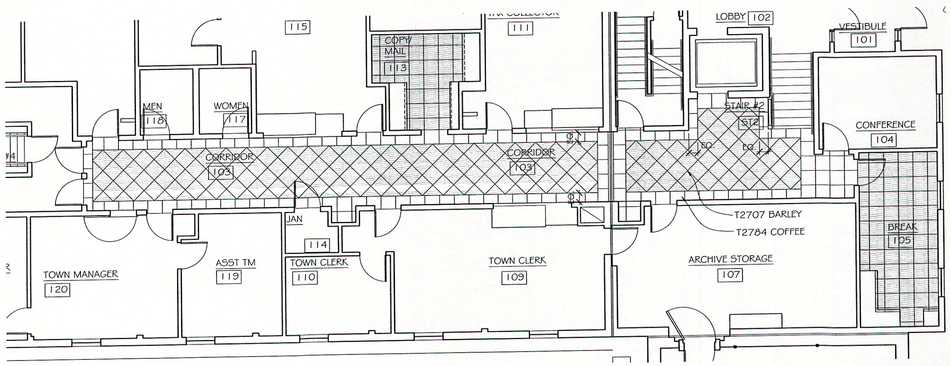

1 FIRST FLOOR PLAN

LINOLEUM FLOOR PATTERN - FIRST FLR
WESTFORD TOWN HALL ADDITION & RENOVATIONS
55 MAIN STREET, WESTFORD, MA
KANG ASSOCIATES, INC. 09/13/10 1/8" = 1'-0"
CSKA 18

DOOR SCHEDULE

DOOR #	FRAME TYPE	DOOR TYPE	DOOR MATL	FIRE RATING	HARD-WARE SET	HEAD/ JAMB DETAIL	REMARKS
~~001A~~	~~F1~~	~~D4~~	~~OAK~~		~~H4~~	~~3~~	~~ADD IN ALT #1~~
001B	F1	D5, PAIR	WD		H10"	3	ADD IN ALT #1 - FLUSH BOLT ON INACTIVE LEAF
~~002A~~	~~F1~~	~~D5~~	~~WD~~	~~1 HR~~	~~H9~~	~~3~~	
ST1-E	F1	D2	OAK	1 HR	H6	4, 18/A11	FIRE LITE GL
ST3-A	F1	D2	OAK	1 HR	H8	7 SIM	FIRE LITE GL MAG. HOLD-OPEN
ST3-B	F1	D2	OAK	1 HR	H8	7 SIM	FIRE LITE GL MAG. HOLD-OPEN
ST3-C	F1	D2	OAK	1 HR	H8	7	FIRE LITE GL MAG. HOLD-OPEN
ST3-D	F1	D2	OAK	1 HR	H8	7	FIRE LITE GL MAG. HOLD-OPEN
ST4-A	EXISTG	EXISTG					PROVIDE NEW CLOSER 3
ST5-A	F1	D5	OAK	1 HR	H6	4	

DOOR SCHEDULE REVISIONS
WESTFORD TOWN HALL ADDITION & RENOVATIONS
55 MAIN STREET, WESTFORD, MA
KANG ASSOCIATES, INC. 3 ADDENDUM #3, 09/21/09 1/8" = 1'-0"
SKA 4

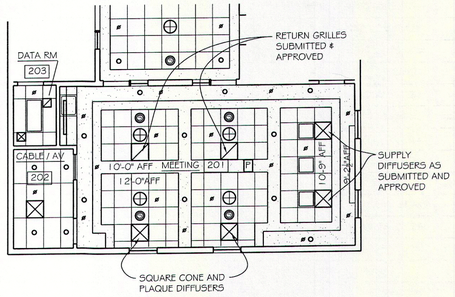

MEETING ROOM CEILING REVISIONS
WESTFORD TOWN HALL ADDITION & RENOVATIONS
55 MAIN STREET, WESTFORD, MA
KANG ASSOCIATES, INC. 09/02/10 1/8" = 1'-0"
CSKA 17c