1 PARTIAL WEST ELEVATION

2 PARTIAL NORTH ELEVATION

see A7

EXTERIOR LIGHT FIXTURE LOCATIONS	CSKA 8
WESTFORD TOWN HALL ADDITION & RENOVATIONS 55 MAIN STREET, WESTFORD, MA	
KANG ASSOCIATES, INC. △ 02/08/10 1/8" = 1'-0"	

PORCH ROOF & RAILING AS-BUILT

NOT TO SCALE

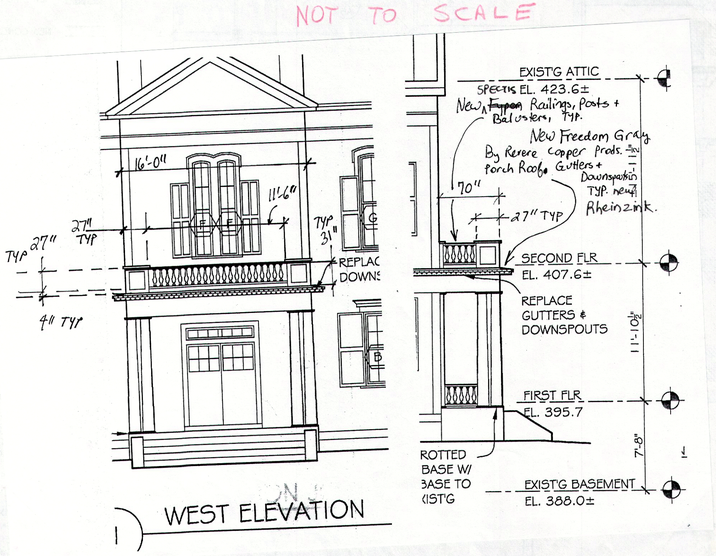

1 WEST ELEVATION

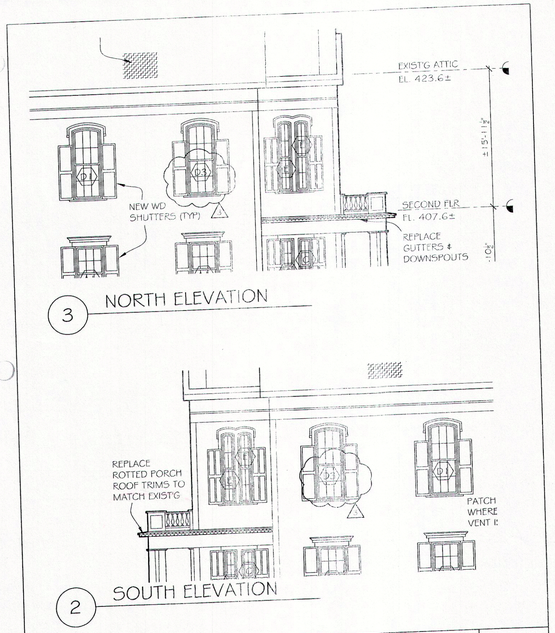

3 NORTH ELEVATION

2 SOUTH ELEVATION

REVISED WINDOW TYPES	SKA 5
WESTFORD TOWN HALL ADDITION & RENOVATIONS 55 MAIN STREET, WESTFORD, MA	
KANG ASSOCIATES, INC. △ ADDENDUM #3, 03/21/09 1/8" = 1'-0"	